

VENDOR:




CONTRACTOR:




**PROPOSED HTTP PROJECT**

**SIMBANET TO TAKIAM CONSULTANCY**

**SITE OVERHEAD CABLE**

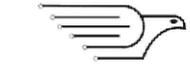CLIENT: 	KEY — PROPOSED FIBER ROUTE — PROPOSED FIBER ROUTE	CONTRACTOR:  KZ Technologies Ltd	SURVEYOR: MORARA DRAWN BY: MORARA		DWG NO. NGONG RD DATE: 16.APRIL . 2025 SHEET: 1 OF 5
	PROJECT: SIMBANET TO TAKIAM CONSULTANCY		DESIGN ENGINEER: MORARA PROJECT ENGINEER: NJOROGE MUGAI	REVISIONS	
		DESCRIPTION		DATE	
		AS-BUILT		TBD	


# TAKIAM CONSULTANCY

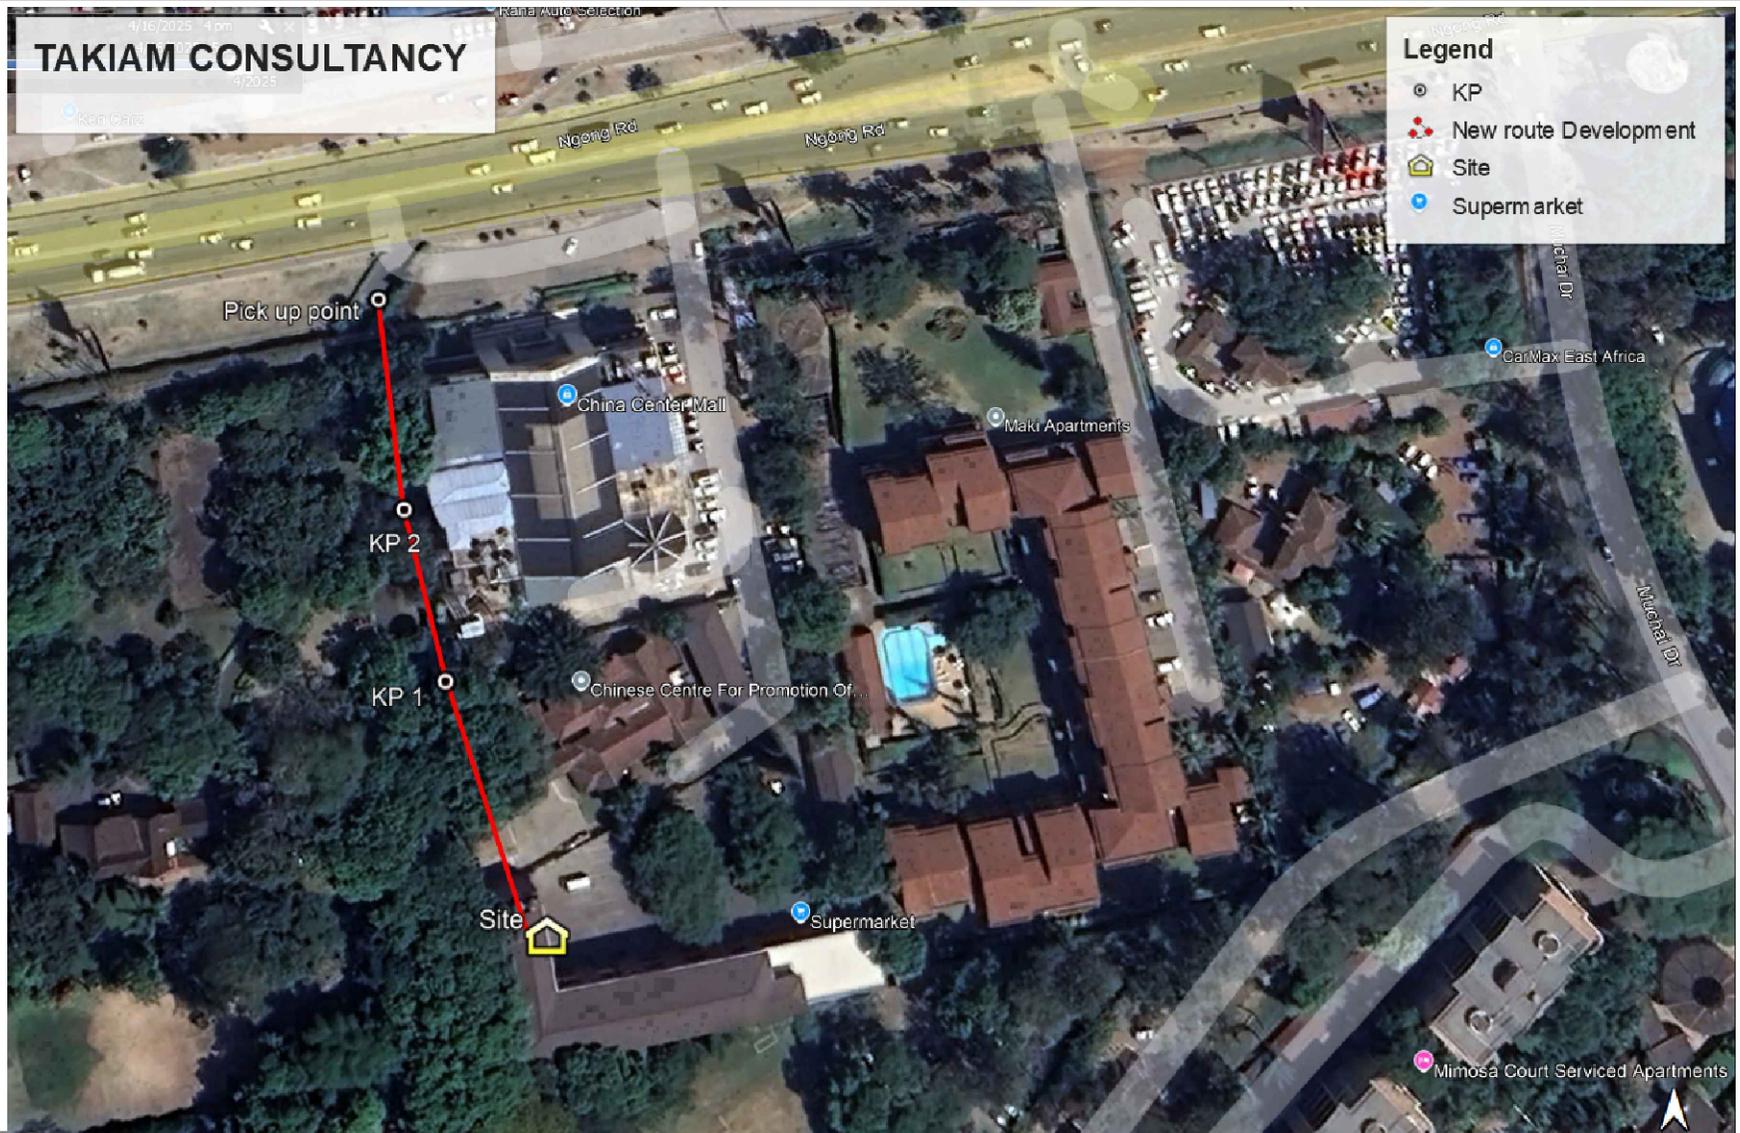

**Legend**

- KP
- New route Development
- 🏠 Site
- 🛒 Supermarket

<p>CLIENT:</p>	<p>KEY</p> <ul style="list-style-type: none"> <li>— PROPOSED FIBER ROUTE</li> <li>— PROPOSED FIBER ROUTE</li> </ul>	<p>CONTRACTOR:</p>	<p>SURVEYOR: MORARA</p> <p>DRAWN BY: ELIZABETH</p>		<p>DWG NO. NGONG RD</p> <p>DATE: 16.APRIL . 2025</p> <p>SHEET: 2 OF 5</p>			
	<p>PROJECT:</p> <p>SIMBANET TO TAKIAM CONSULTANCY</p> <p>Road Site: NGONG RD</p> <p>Cable</p>		<p>DESIGN ENGINEER: ELIZABETH</p> <p>PROJECT ENGINEER: NJOROGE MUGAI</p>	<p>REVISIONS</p> <table border="1"> <thead> <tr> <th>DESCRIPTION</th> <th>DATE</th> </tr> </thead> <tbody> <tr> <td>AS-BUILT</td> <td>TBD</td> </tr> </tbody> </table>		DESCRIPTION	DATE	AS-BUILT
DESCRIPTION	DATE							
AS-BUILT	TBD							

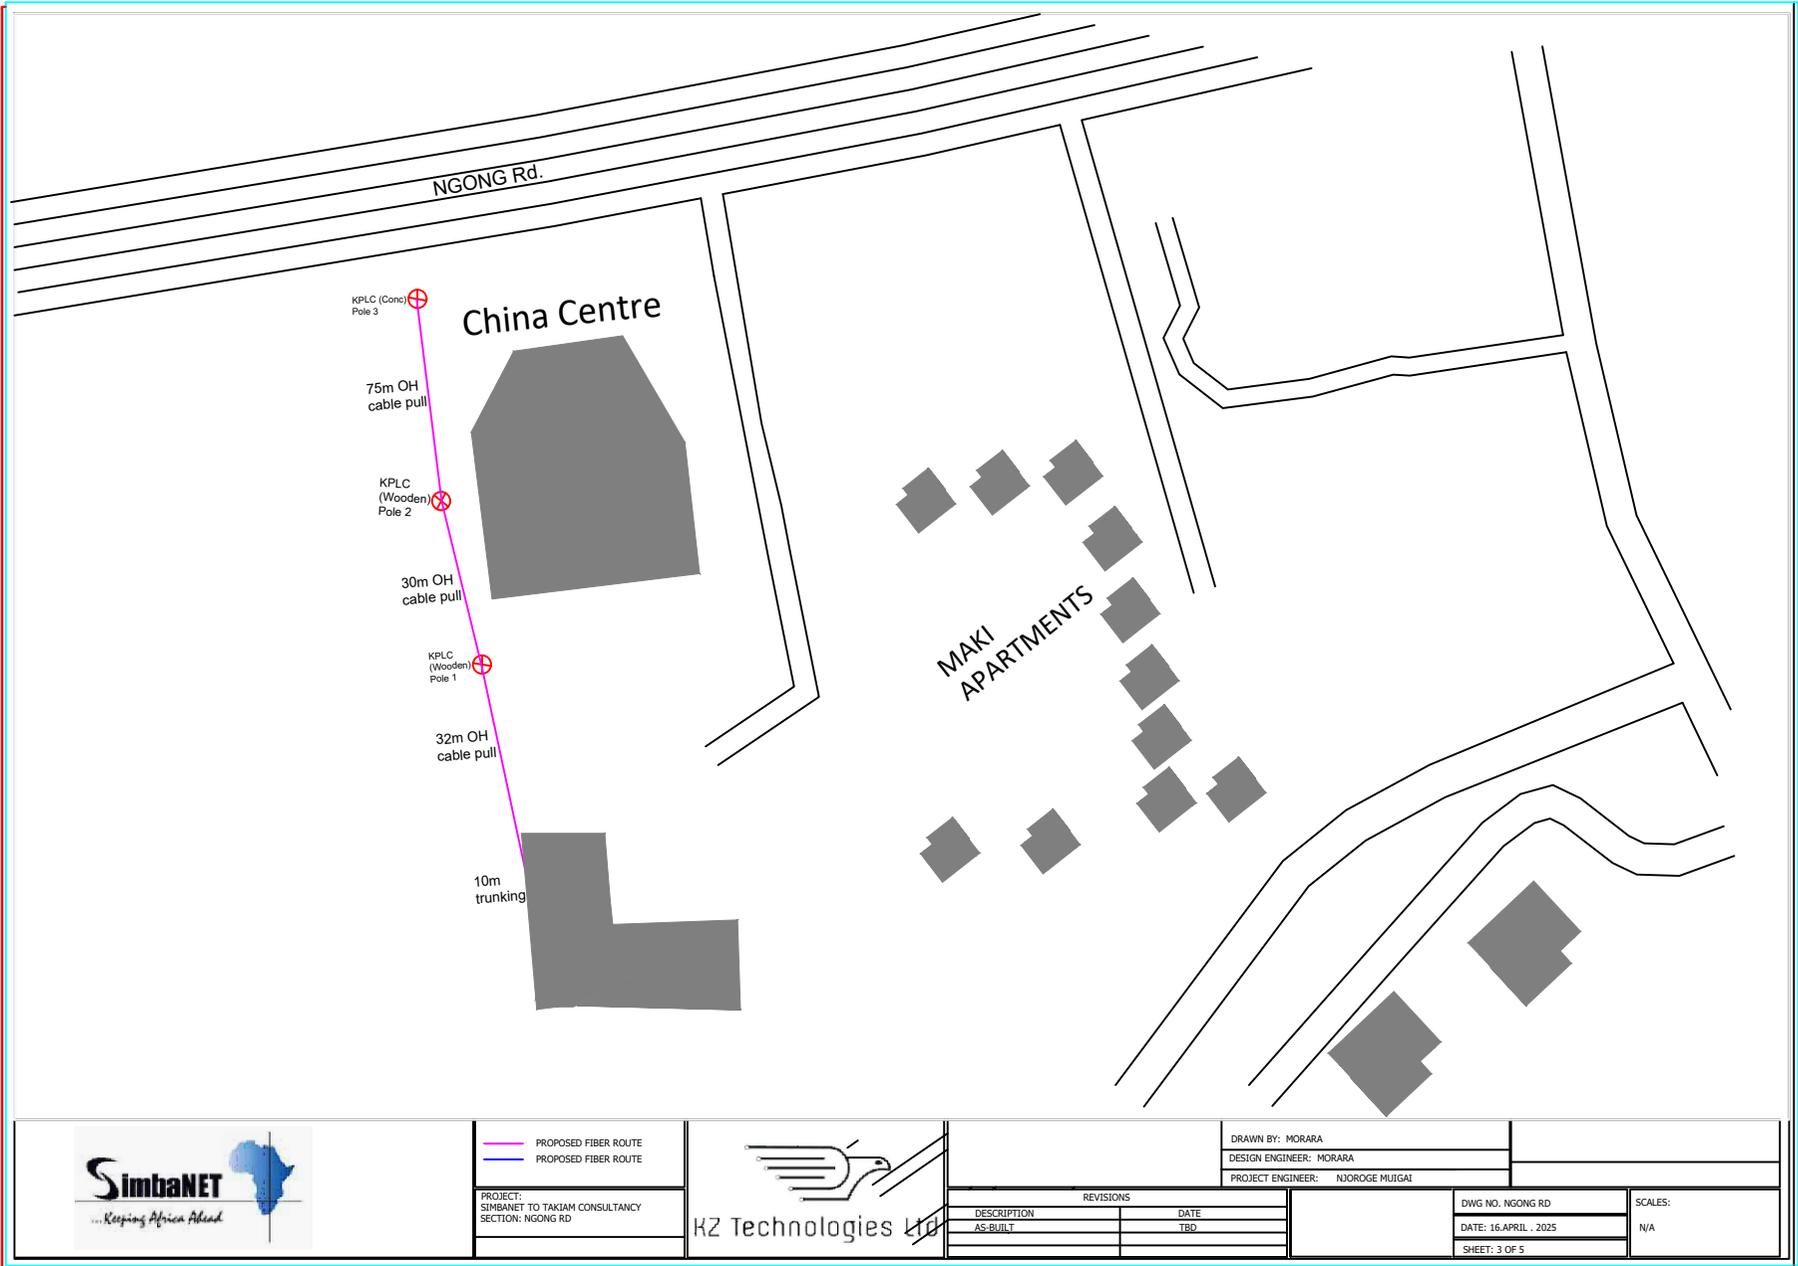

— PROPOSED FIBER ROUTE  
— PROPOSED FIBER ROUTE


PROJECT: SIMBANET TO TAKIAM CONSULTANCY  
 SECTION: NGONG RD




DRAWN BY: MORARA  
 DESIGN ENGINEER: MORARA  
 PROJECT ENGINEER: NJOROGE MUIGAI

REVISIONS	
DESCRIPTION	DATE
AS-BUILT	TBD


DWG NO. NGONG RD	SCALES:
DATE: 16.APRIL . 2025	N/A
SHEET: 3 OF 5	

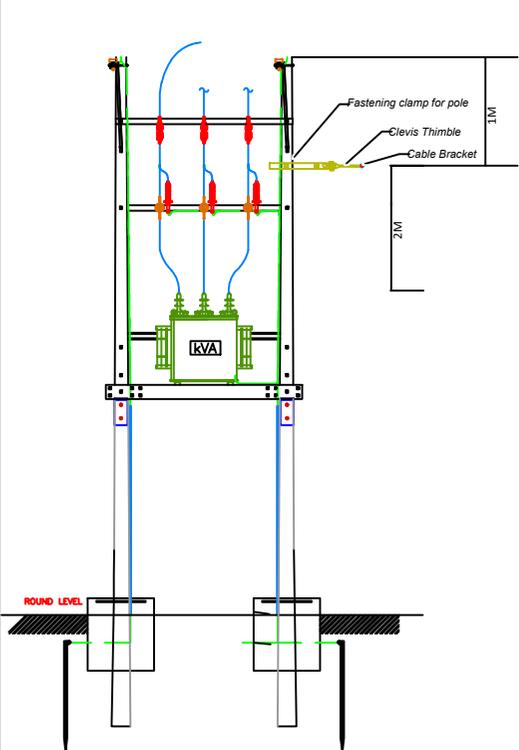


EXTENSION ROD ON POLES WITH TRANSFORMERS

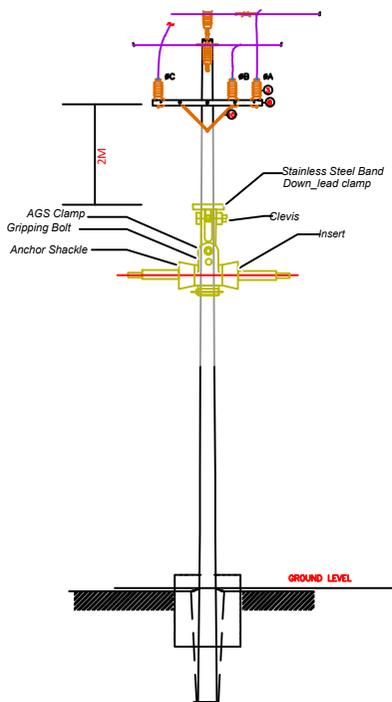

TENSION CLAMP ON MV POLES DISTANCE 1M ON LV POLES

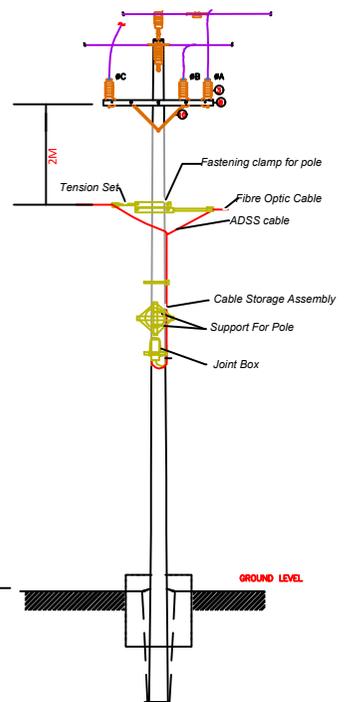

JOINT BOX AND SLACK STORAGE ON MV POLES DISTANCE 1M ON LV POLES

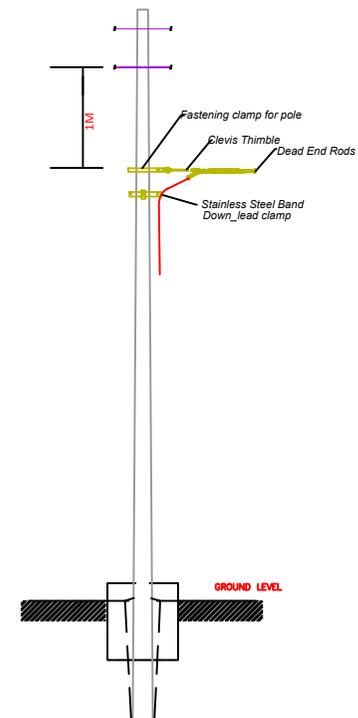

SUSPENSION CLAMP ON LV POLES DISTANCE 2M ON MV POLES

CLIENT:



KEY  
 — PROPOSED FIBER ROUTE  
 — PROPOSED FIBER ROUTE

PROJECT:  
 SIMBANET TO TAKLAM CONSULTANCY  
 Road Site: NGONG RD  
 Cable

CONTRACTOR:



SURVEYOR: MORARA  
 DRAWN BY: ELIZABETH  
 DESIGN ENGINEER: MORARA  
 PROJECT ENGINEER: NJOROGI MUIGAI

REVISIONS	
DESCRIPTION	DATE
AS-BUILT	TBD

DWG NO. NGONG RD  
 DATE: 16 APRIL, 2025  
 SHEET: 3 OF 5

SCALE:  
 HORIZONTAL : 2500

**SIMBANET**

**TAKIAM CONSULTANCY**

CLIENT:



KEY  
— PROPOSED FIBER ROUTE  
— PROPOSED FIBER ROUTE

PROJECT:  
SIMBANET TO TAKIAM CONSULTANCY  
SECTION: NGONG RD

CONTRACTOR:



**KZ Technologies Ltd**

SURVEYOR: MORARA  
DRAWN BY: MORARA  
DESIGN ENGINEER: MORARA  
PROJECT ENGINEER: NJOROGE MUIGAI

REVISIONS	
DESCRIPTION	DATE
AS-BUILT	TBD

DWG NO. NGONG RD  
DATE: 16.APRIL . 2025  
SHEET: 4 OF 5

SCALES:  
N/A