

KENEX RELOCATION



CLIENT:

KEY

	PROPOSED FIBER ROUTE
	PROPOSED FIBER ROUTE

PROJECT:
KENEX RELOCATION
SECTION: OFF MOMBASA RD

CONTRACTOR:


SURVEYOR: MORARA
DRAWN BY: ELIZABETH
DESIGN ENGINEER: ELIZABETH
PROJECT ENGINEER: GEORGE MORARA

REVISIONS	
DESCRIPTION	DATE
AS-BUILT	TBD

DWG NO. OFF MOMBASA RD
DATE: 19th JUNE, 2025
SHEET: 1 OF 2

SCALES:
N/A

MAIN WORKLOAD														
Route Survey [M]	F.O.C [M]	Materials											Route Cleaning	OSP Cabro(m)
		Trunking (m)	Conduits (m)	UPS	ODF	BG-Patch Cord(5m)	CAT 6 (m)	Metro Switch	Cabinet 6u	ONU	PIG TAIL	SFP 10KM		
300	300	0	0	0	1	3	0	0	1	0	3	0	0	0
POLES		POLE ACCESSORIES											GI Pipes	
KPL	Zuku pole	U.P.B	Storage bracket	J.Hook	Downlead Clamps	Tension Anchor	Steel Straps (m)	cable tray	Saddle clips	Stay Blocks	Dead End	Above 5m	Under 5m	
3	0	0	6	1	2	4	20	0	20	0	0	0	0	

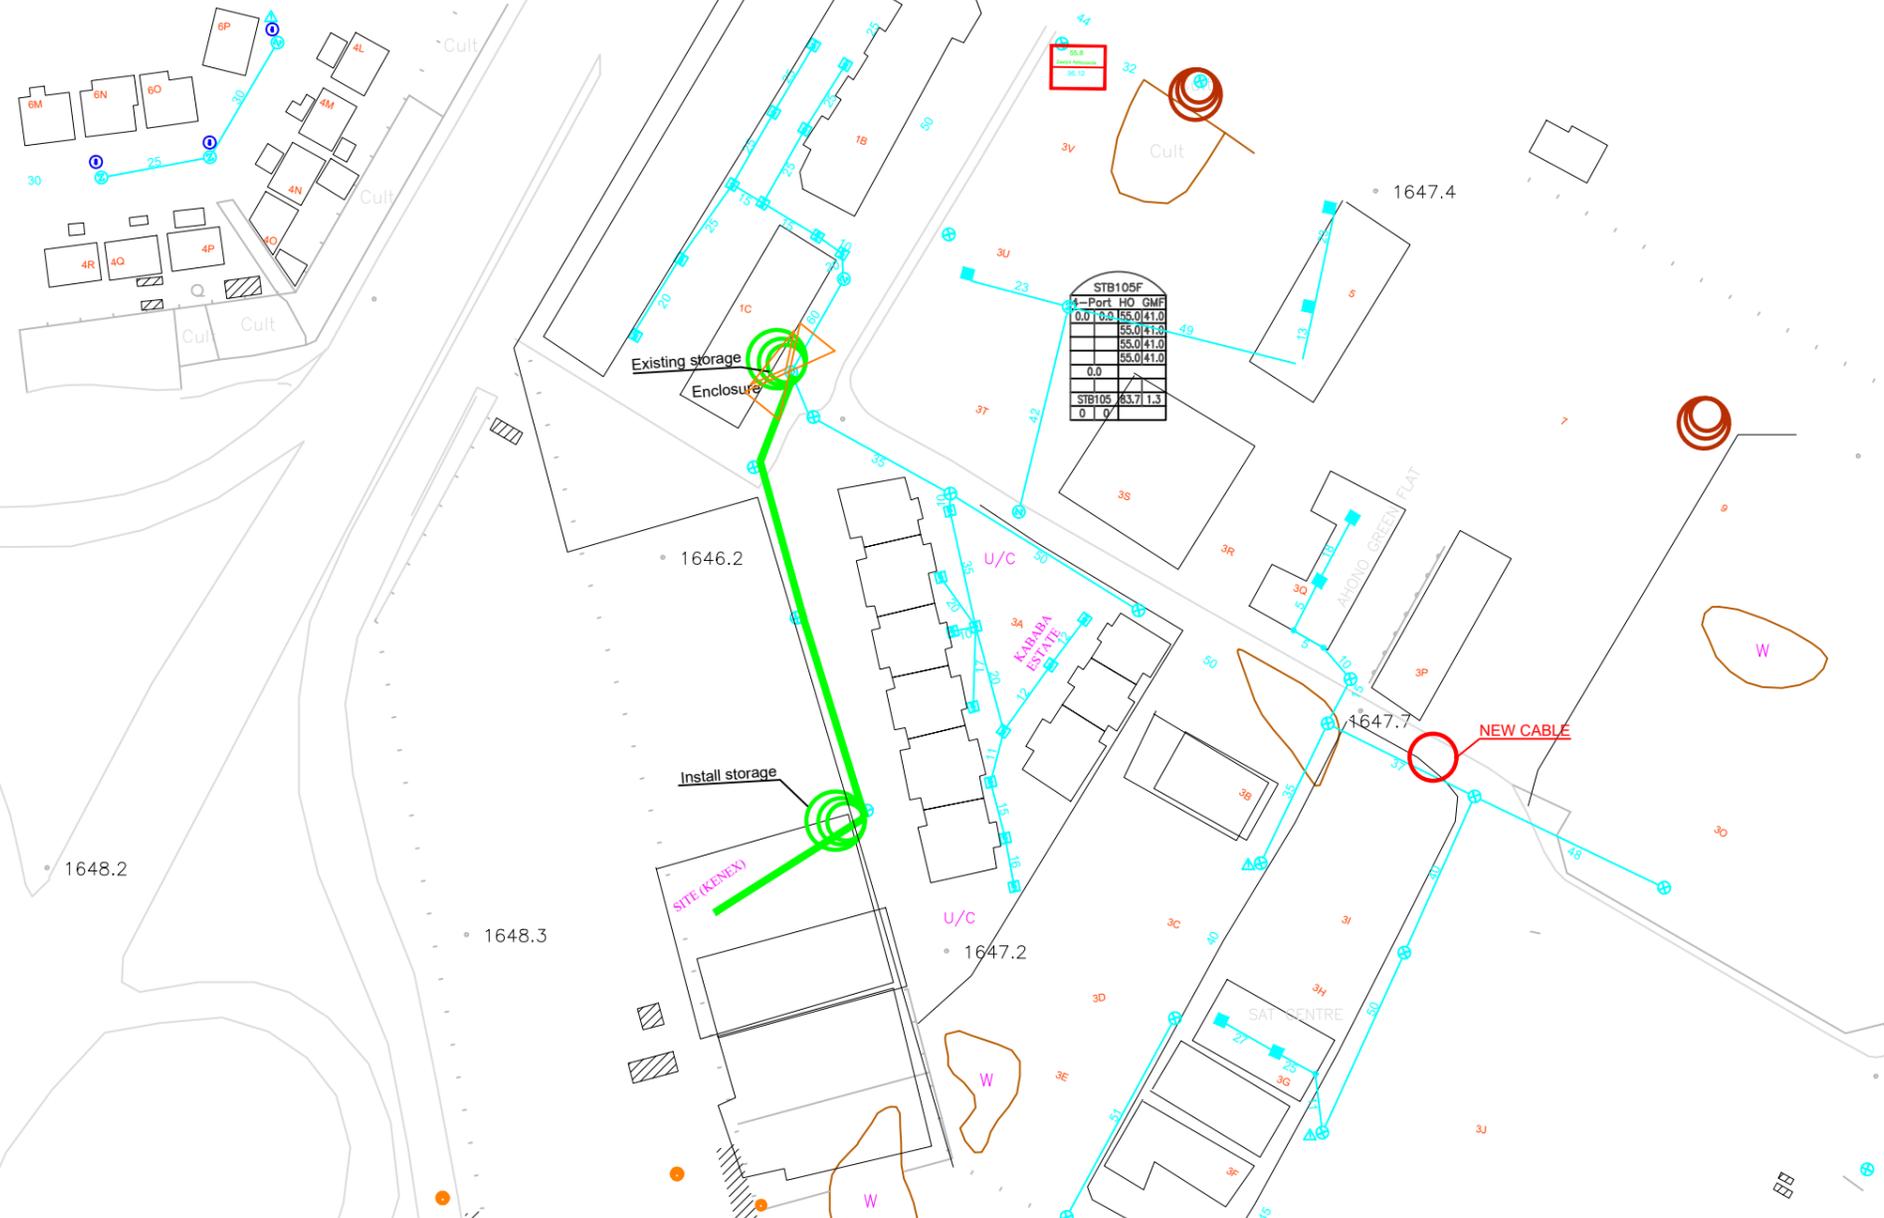

STB105F	4-Port HO GMF
0.0	155.0
55.0	41.0
55.0	41.0
55.0	41.0
0.0	55.0
55.0	41.0
0.0	0.0
STB105	23.7
0.0	1.3
0.0	0.0

CLIENT:

KEY
 --- PROPOSED FIBER ROUTE
 --- PROPOSED FIBER ROUTE

PROJECT:
 KENEX RELOCATION
 SECTION: OFF MOMBASA RD

CONTRACTOR:

REVISIONS	
DESCRIPTION	DATE
AS-BUILT	TBD

SURVEYOR: MORARA
 DRAWN BY: ELIZABETH
 DESIGN ENGINEER: ELIZABETH
 PROJECT ENGINEER: GEORGE MORARA

DWG NO. OFF MOMBASA RD
 DATE: 19th, JUNE, 2025
 SHEET: 2 OF 2

SCALES:
 N/A